

				UIL 74.331 25.613m 1:18 DIL 72.927	TP17 UIL 72 11.8	0.4 7.9 0.4 7.9 0.4 0.4 0.4 0.4 0.7 0.7 0.7 0.7 0.7 0.7 0.7	Jump Up IL 75.513 Depth1.20 Ramp Ris IL 74.34 Depth1.3 Ramp Riser IL 73.525 Depth1.185 - UIL 72.22 0.872m [1:27 DIL 72.196	er LOT 6 SP34 81 81 8 SP34	- 2 Rai - 2 IL 6166 De UIL 25	5 - 71.593	LOT 5 SP34616 Ramp Rist IL 72.254 Depth1.25 UIL 71.593 22.785m 1:45 DIL 71.092 50 4.1	er Ramp R + IL 71.9 50 Depth1. 8 UIL 71. 51 17.7	166 SF iser Rar 43 IL .281 Dep
					LOT 800 SP346166	DIL 72.347 9.506m 1:66 DIL 72.203 E1-5 0.8 0.8 0.8 0.8 0.8 0.8 0.8 0.8 0.8 0.8	¢600 SL 73.79	ranch F 16 252 [5	/ UIL 71 9.8 DIL 71 <u>E3-</u> 0.7 0.7 0.7 0.7 0.7 0.7 0.7 0.7 0.7 0.7	r Ramp I IL 71. 0 Depth	Riser Ram 920 IL 1.495 Dep 33 L(UIL 71.242 9.874m 1:65 DIL 71.092 E3-3 7.0 1.0 1.0 1.0 1.0 1.0 1.0 1.0 1.0 1.0 1	Ramp Rise 1.1 - 71.765 Depth1.249 LOT 31 SP346166
Land	dPartne	ers Pty Ltd, h s shown on t	RAL SURVEYOR (QLD) CERT hereby certify that the horizon his plan are a true and correc	tal and vertical l		LOT 30 RP81010	7			RI	LOT 4 2810107		LC RP8
Sigr (Aut Land I, 1. 2. 3. 4.	horised dPartne AINEER The appr The desig	I Delegate) ers Pty Ltd, F S CERTIFIC information roved drawir new water a gned and co represents ept respons	Date 13/11/20 Registered Cadastral Surveyo ATION ATION ATION ACCORTAGE AND A CONTRACT AND A CONT	or SBQ ID 4118 tt: ocument is in co by this drawing h the SEQ Code istructed works. tained in this dra	have been e.			SEWER R				E-100 SDR21 110 PE-100	
\1	2 1 INDEX	13/11/2024 25/10/2024 DATE	DEPTH UPDATES INITIAL ISSUE	VISIONS				МJK MJK DRAWN	LS RA CHECKED	LS RA PASSED	DRAWN CHECKE PASSED		13/11/2024 13/11/2024 13/11/2024 13/11/2024 DATE

LOT 7 SP346166 Ramp Riser IL 71.543 Depth1.409		LOT 9 SP346166 amp Riser L 71.027 epth1.216	LOT 10 SP346166 Ramp Riser IL 70.599 Deset 129(LOT 11 SP346166 Ramp Riser IL 70.046 Depth1.297	LOT 12 SP346166 Ramp Riser IL 69.501	LOT 13 SP346166 Ramp Riser IL 69.028 Depth1.499	LOT 14 SP346166 Stub IL 68.625	LOT 15 SP346166 Jump Up IL 68.191	LOT 16 SP346166 Jump Up IL 67.806 Depth1.358	LOT 17 SP346166 Ramp Riser IL 67.361	LOT 18 SP346166 Stub IL 67.147 Depth1.390	LOT 901 SP346166	LOT 28 RP225105
6.1	UIL 70.703 10.907m 1:45] [JIL 70.443 2.779m I:31 DIL 70.354	1:31 DIL 69.965 50 6.3	UIL 69.965 12.403m 1:31 DIL 69.569 5.8	2.0 g	6.0	Depth1.499 UIL 66.678 6.603m 1:72 DIL 66.586 4.3 UIL 66.586	6.3 X X TD2 7	UIL 67.080 34.057m 1:101 DIL 66.744 ** 6.0 UIL 66.744	Depth1.436	0.9 MS3-71 Ø600 SL 68.370 MS4-8		
UIL 70.812 9.808m 1:89 DIL 70.703	Ø600 SL 72.219	UIL 70.450 10.637m 1:111 DIL 70.354 E3-1A		UIL 69.797 10.536m 1:46 DIL 69.569	BRENTWOOD UI DI 17 26 Jump 14 6166 Jeptho			56.785 2.774m TP3-8 1:82 56.639 P2-8	5.071m 1:77 DIL 66.678 <u>2.6</u> Jump Up L IL 68.022 SF Depth1.189	DIL 66.785	¢600 SL 68,386		LOT 27 RP225105
Riser Ramp 765 IL 7 1.249 DeptI 31 LO ⁻ 5166 SP34	Riser Ramp .262 IL 71 11.330 Deptt - 30 LOT 66166 SP34		th1.405 Dept	DT 27 346166)T 25 Jump 346166 Depth)T 24 Stu 346166 IL 66. Depth(0.868	23. DIL 6 UIL 66 10. DIL 66.	1:106 6.415 359 19m 1:857 240 MS1-8	Stub IL 66.911 L Depth1.302SP	LOT 2 SP3461	298 Depth1.280	LOT 900 SP346166	LOT 26 RP225105
LOT 5 RP810107		LOT 6 RP81010	7		LOT 13 RP81010	SL 68.0 UIL 66.17 0.729 1:5 DIL 66.15	23/ 72/ 72/ 72/ 72/ 72/ 72/ 72/ 72/ 72/ 72	1:162 1:162 DIL 66	5.209 m 5.172 LOT	T 14 10107		LOT 32 RP810108	

N.O



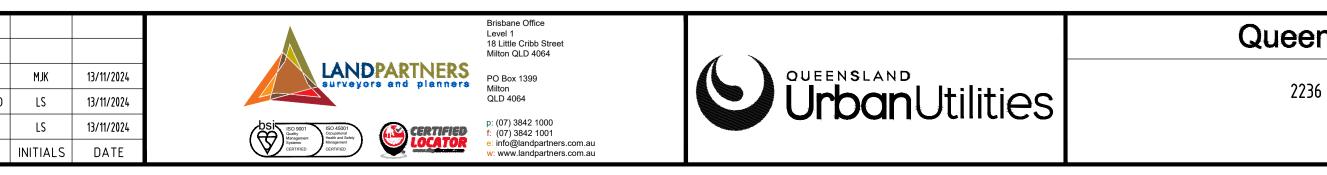

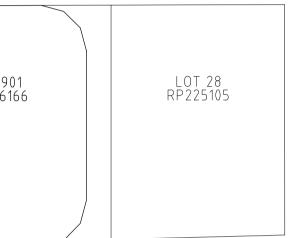

	_		_					
		AS CO	NSTRU	CTED)			
	0	10	1:500 20	30	37.5			
	ALL DISTANCES IN METRES							
ensland Urban Utilities	SCALI SHEE		SHEETS					
36 BEAUDESERT ROAD, CALAMVALE AS-CONSTRUCTED WATER 23-PNT-69061			wing no. SS8222-()00-81-	- 2			